


- **11 Parks**
- **17 field conversions (32% of all County MP fields)**
- **Fields selected as a result of heavy programming**
- **Total Allocation of \$27,572,000 FY18 – FY23**
- **Why synthetic turf?**
- **Advantages/Concerns**
- **User group input (ok with turf, field lines, etc.)**

Synthetic Turf Project List



Park	Proposed Improvement	Fiscal Year Allocation	Amount Allocated
West Boynton	Convert MP1 to syn. turf	FY18	\$1,000,000
Caloosa Park	Convert SB4 to MP turf, MP1, MP3 to syn. turf	FY20	\$4,000,000
County Pines	Convert MP 9 and MP 10 to syn. turf	FY20	\$3,000,000
Dyer Park	Multipurpose Fields 3,4,5 to syn. turf	FY20	\$6,000,000
John Prince Triplex	Convert SB2 and SB3 to syn. Turf	FY20	\$3,222,000
Logggers Run	Convert MP 1 and MP 2 to syn. turf	FY20	\$3,200,000
Buttonwood	Convert MP3 and open play to syn. Turf	FY21	\$900,000
Buttonwood	Convert MP2 to syn. Turf	FY23	\$1,500,000
Glades Pioneer	Convert MP5 to syn. Turf	FY23	\$2,000,000
West Boynton	Convert MP2 to syn. Turf	FY23	\$1,000,000
Westgate	Convert MP1 to syn. turf	FY23	\$1,750,000
		Total Allocation	\$27,572,000

Synthetic Turf Project Locations

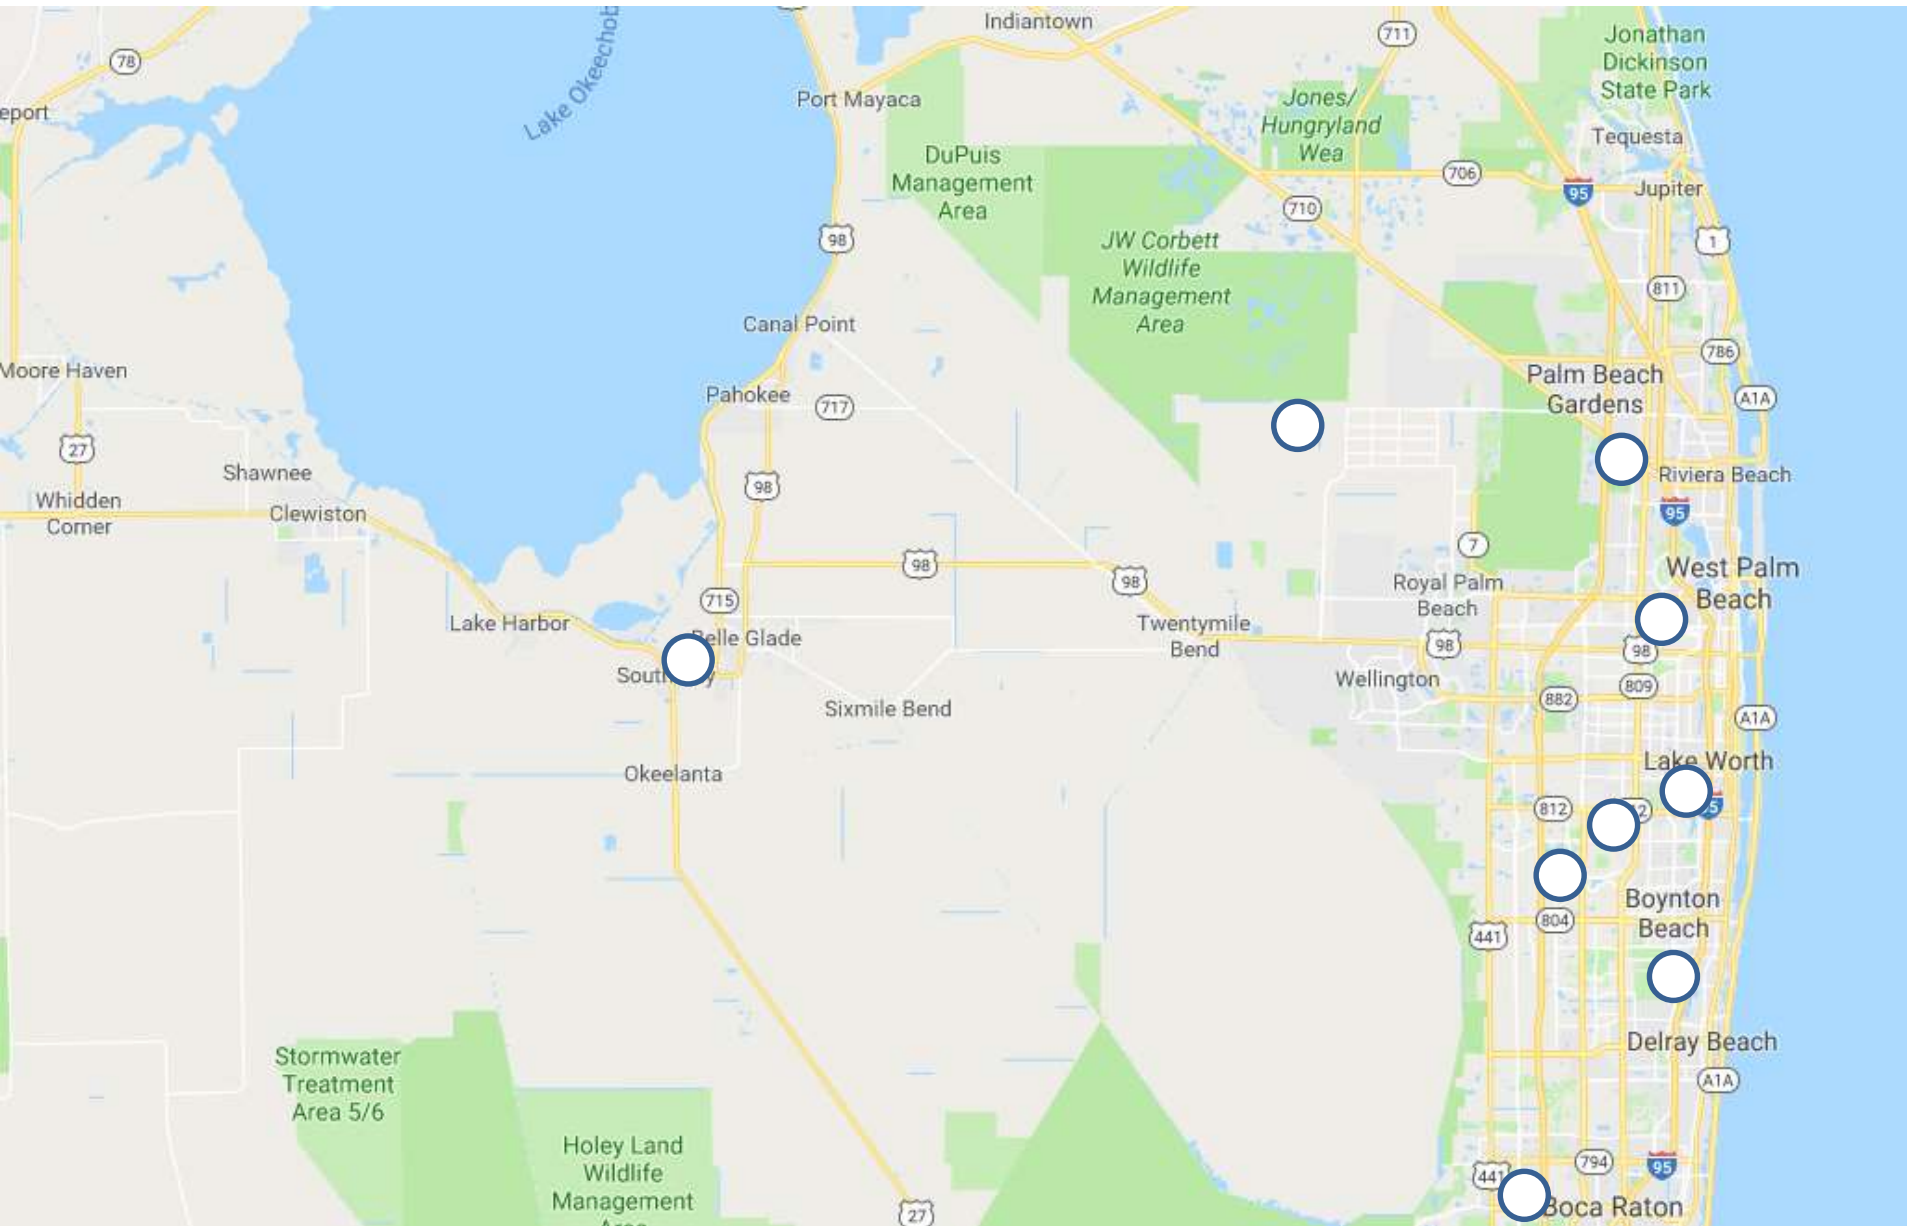

Buttonwood Park



PALM BEACH COUNTY
 PARKS & RECREATION DEPARTMENT
 APPROVED BY: [Signature]
 DESIGNED BY: JAMES H. CARLITTELL & WAINWING
 DATE: [Date]
 DRAWN BY: [Name]
 SCALE: [Scale]

BUTTONWOOD PARK AS-BUILT PLAN

REVISED



SHEET NO.
 1 OF 1

811 Know what's below. Call before you dig.

Caloosa Park



PALM BEACH COUNTY
 PARKS & RECREATION DEPARTMENT
 PROJECT # 2020000000
 DRAWN BY: A. MARTIN
 DATE: 10/20/2020
 DESIGNED BY: 10/20/2020
 FILE NAME: CALOOSA.PARK.PLAN

CALOOSA PARK AS-BUILT PLAN


REVISIONS



SHEET NO. 1 OF 1



County Pines Sam Friedland Park

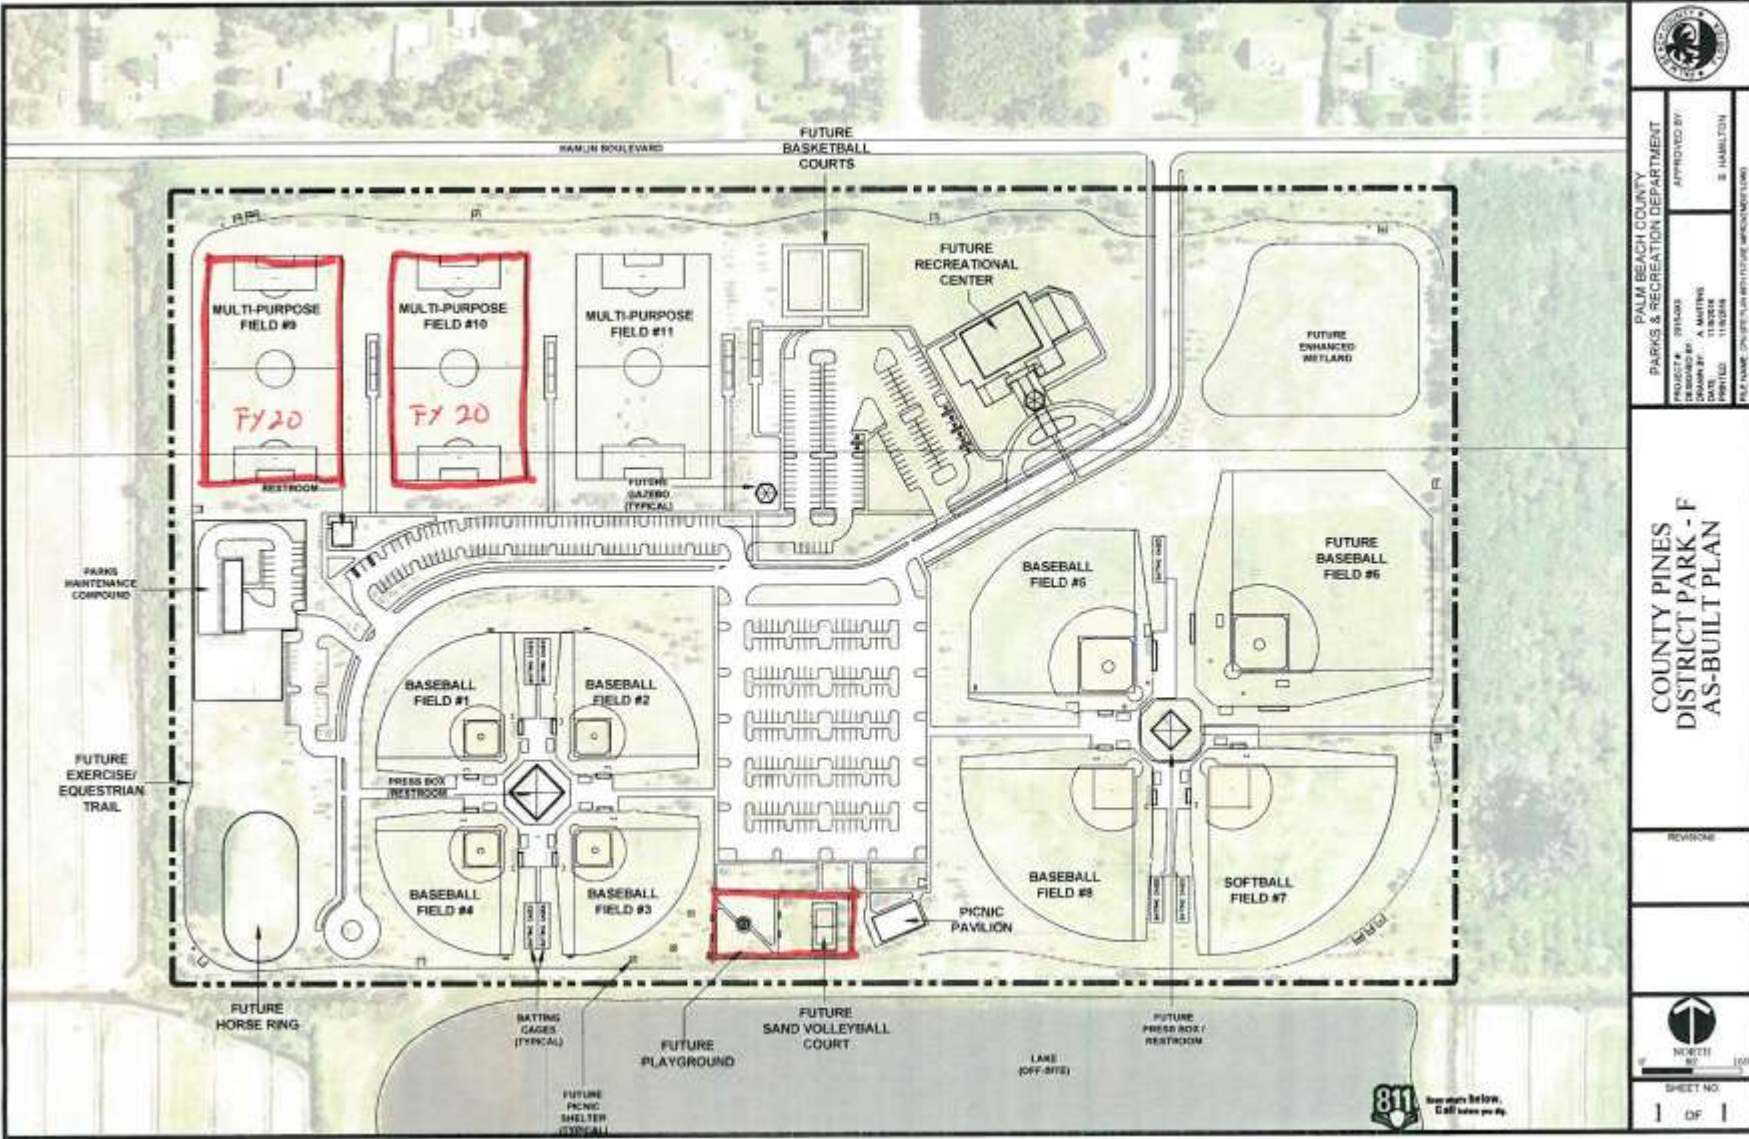

PALM BEACH COUNTY
 PARKS & RECREATION DEPARTMENT
 APPROVED BY:
 PROJECT # 01006
 DRAWN BY: A. MARTIN
 DATE: 11/2006
 PLOT: 11/2006
 FILE NAME: COUNTY PINES DISTRICT FUTURE AS-BUILT PLAN

COUNTY PINES DISTRICT PARK - F AS-BUILT PLAN

REVISION:



SHEET NO.
 1 OF 1



Dyer Park



PALM BEACH COUNTY PARKS & RECREATION DEPARTMENT	APPROVED BY: _____ B. HAMILTON
PROJECT # 0115-004 DESIGNED BY A. MARINE DRAWN BY J. MARINE CREATED 05/18/2015 FILE NAME: 0115004.DWG	
DYER PARK AS-BUILT PLAN	
REVISIONS	
SHEET NO. 1 of 1	

811 See map below. Call before you dig.

Loggers Run Park



PALM BEACH COUNTY
 PARKS & RECREATION DEPARTMENT

APPROVED BY:	B. HAMILTON
DESIGNED BY:	A. MATTHEW
DRAWN BY:	M. WOOD
PRINTED:	10/2011
FILE NAME:	LOGGERS RUN AS-BUILT.DWG


LOGGERS RUN PARK AS-BUILT PLAN



SHEET NO.
 | OF |



Glades Pioneer Park

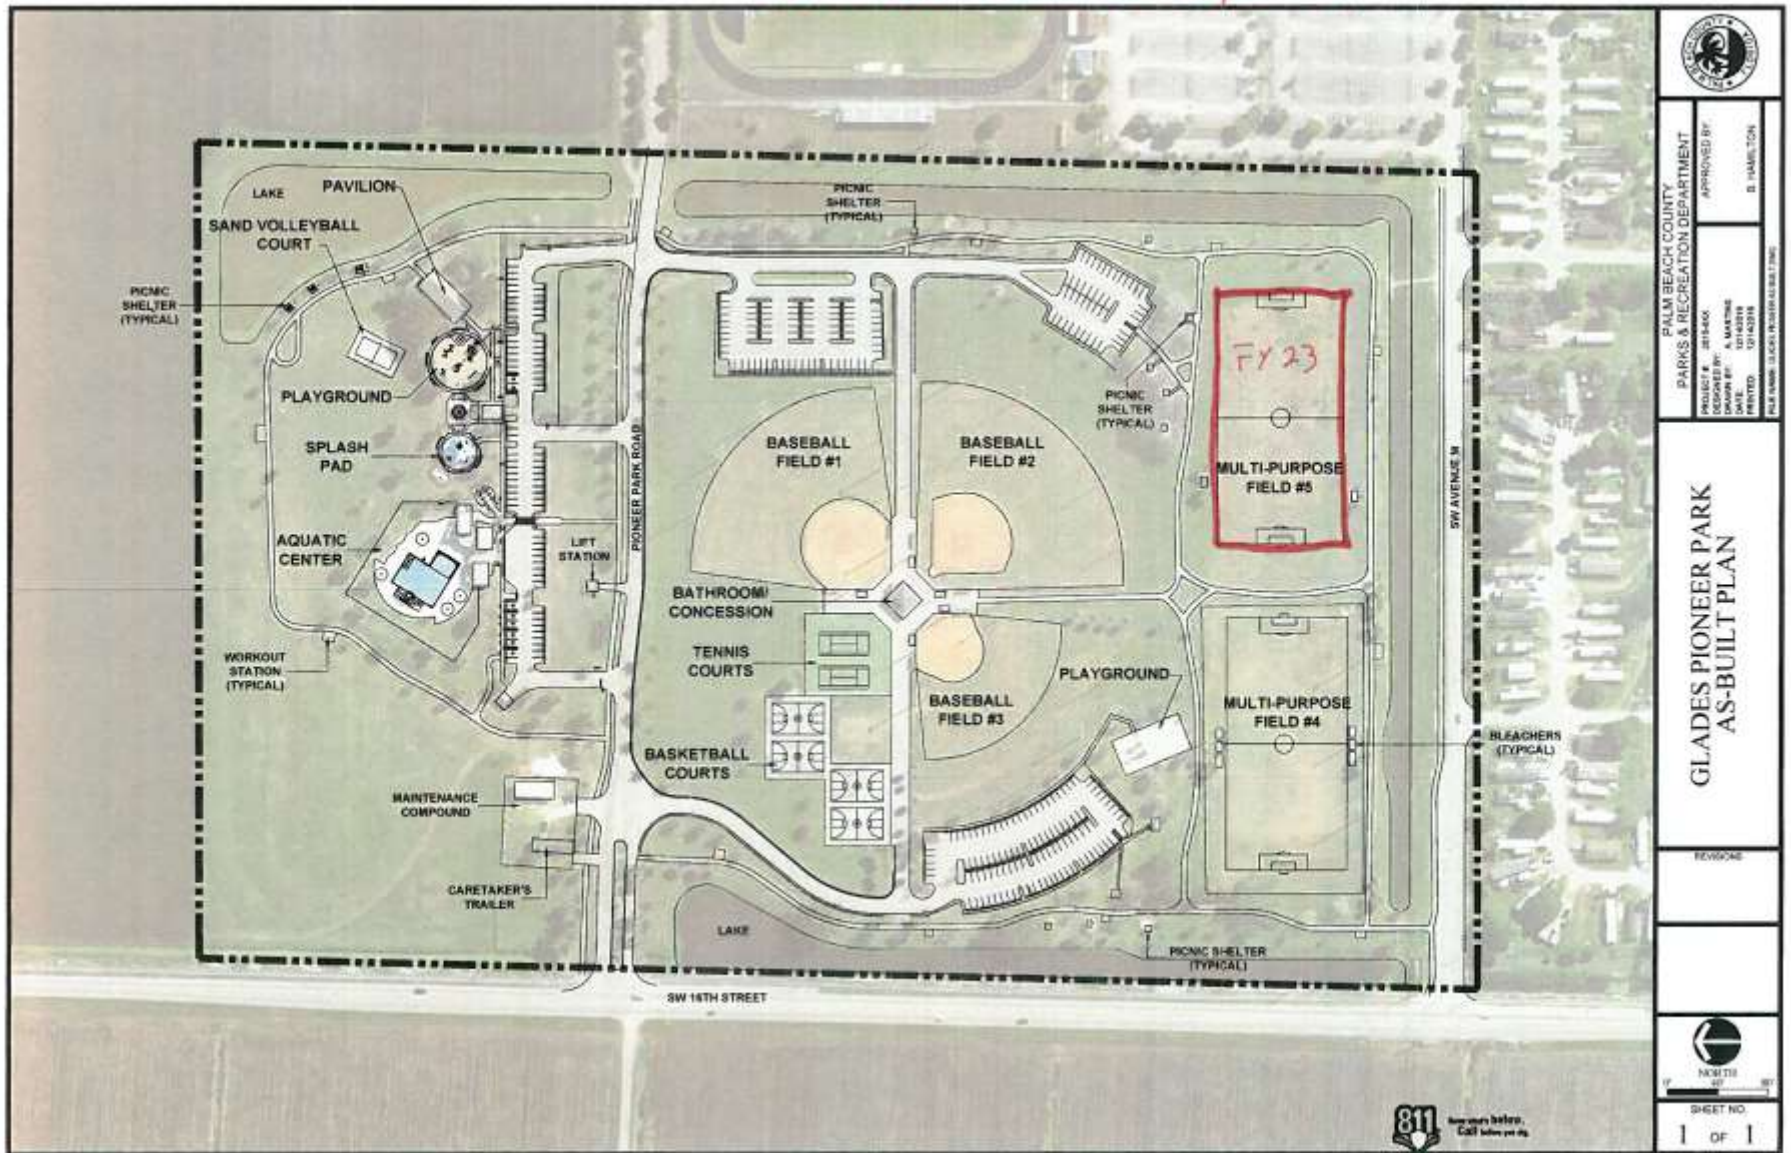


	PALM BEACH COUNTY PARKS & RECREATION DEPARTMENT	APPROVED BY  B. HAMILTON
	PROJECT # 26246 DESIGNED BY: A. MARTIN DATE: 07/14/2019 DRAWN: 07/14/2019 FILE NAME: GLADES PIONEER AS-BUILT.DWG	GLADES PIONEER PARK AS-BUILT PLAN
REVISIONS		
NORTH 		
SHEET NO. 1 OF 1		

John Prince Park – Triplex Area




West Boynton District Park

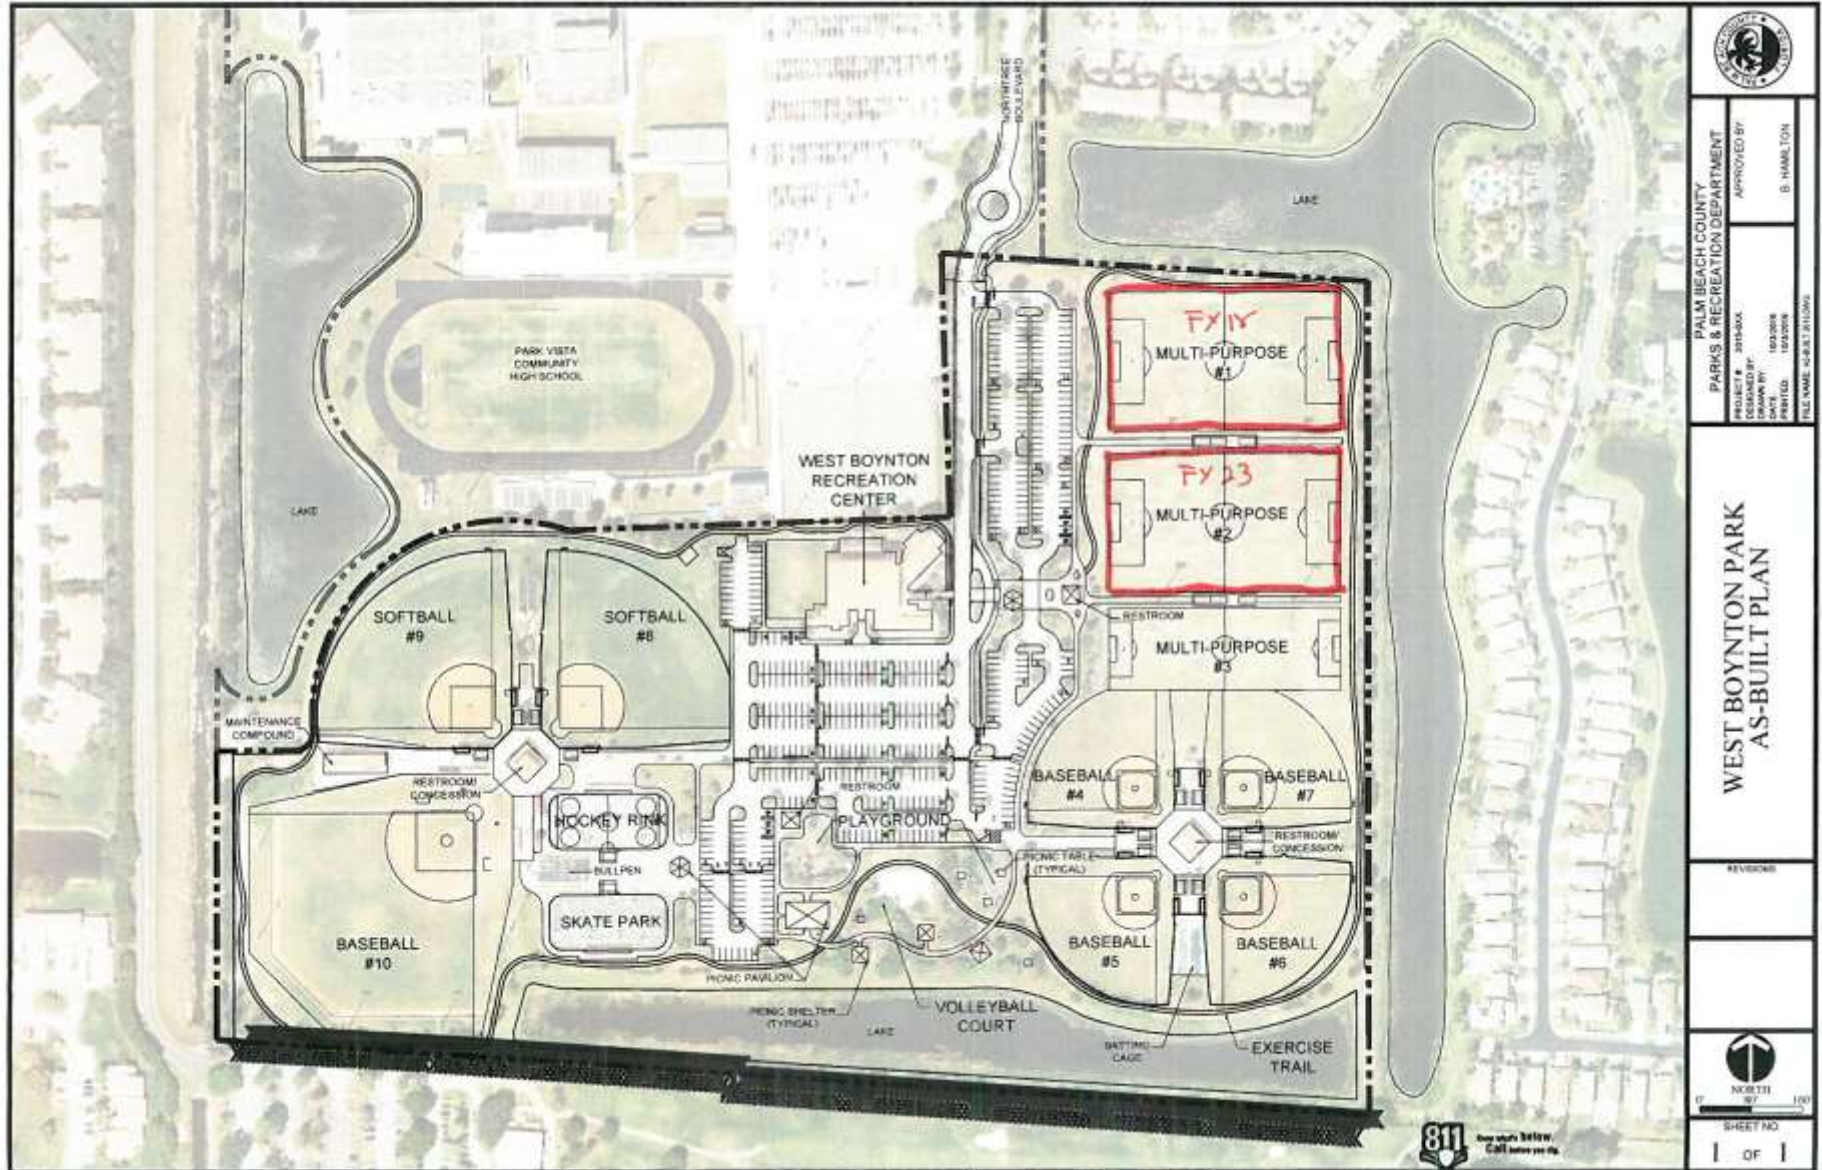

	
PALM BEACH COUNTY PARKS & RECREATION DEPARTMENT	
PROJECT #315-000	APPROVED BY B. HAMILTON
DRAWN BY DATE PARTIAL	10/20/08 10/20/08
FILE NAME: 0-0-01-0100	
WEST BOYNTON PARK AS-BUILT PLAN	
REVISIONS	
 NORTH 0 50 100	
SHEET NO OF	



Westgate Park and Community Center

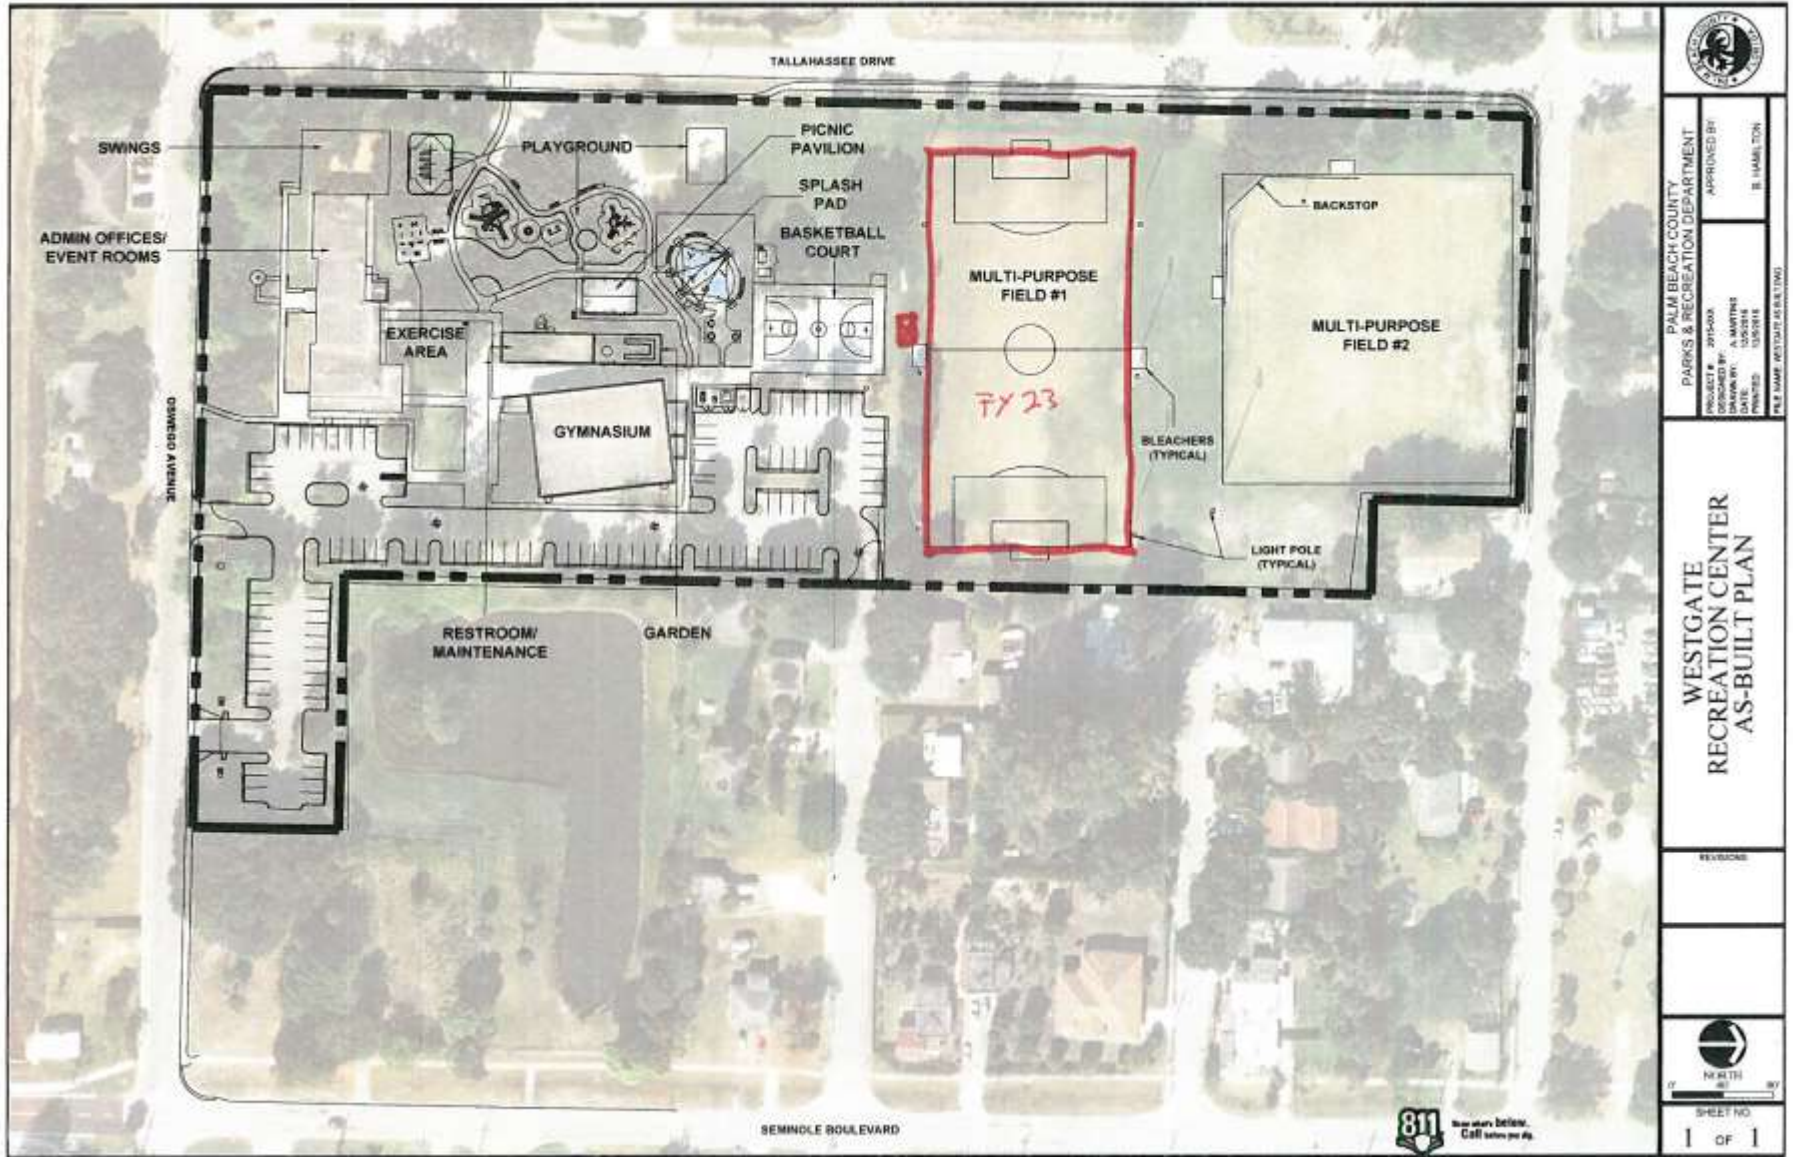

Glades Pioneer Park Orange Bowl Field



Completion Timeline



- **Funding for six projects will be available October 1st.**
- **Procurement method TBD, likely separate contracts for procurement and installation.**
- **Up to one year for engineering, procurement and approvals.**
- **Build time of 90 to 120 days per field.**
- **Installation timed to coincide with low field usage.**